


A-A2 Building Section 1:50



A-A3 Building Section 1:100

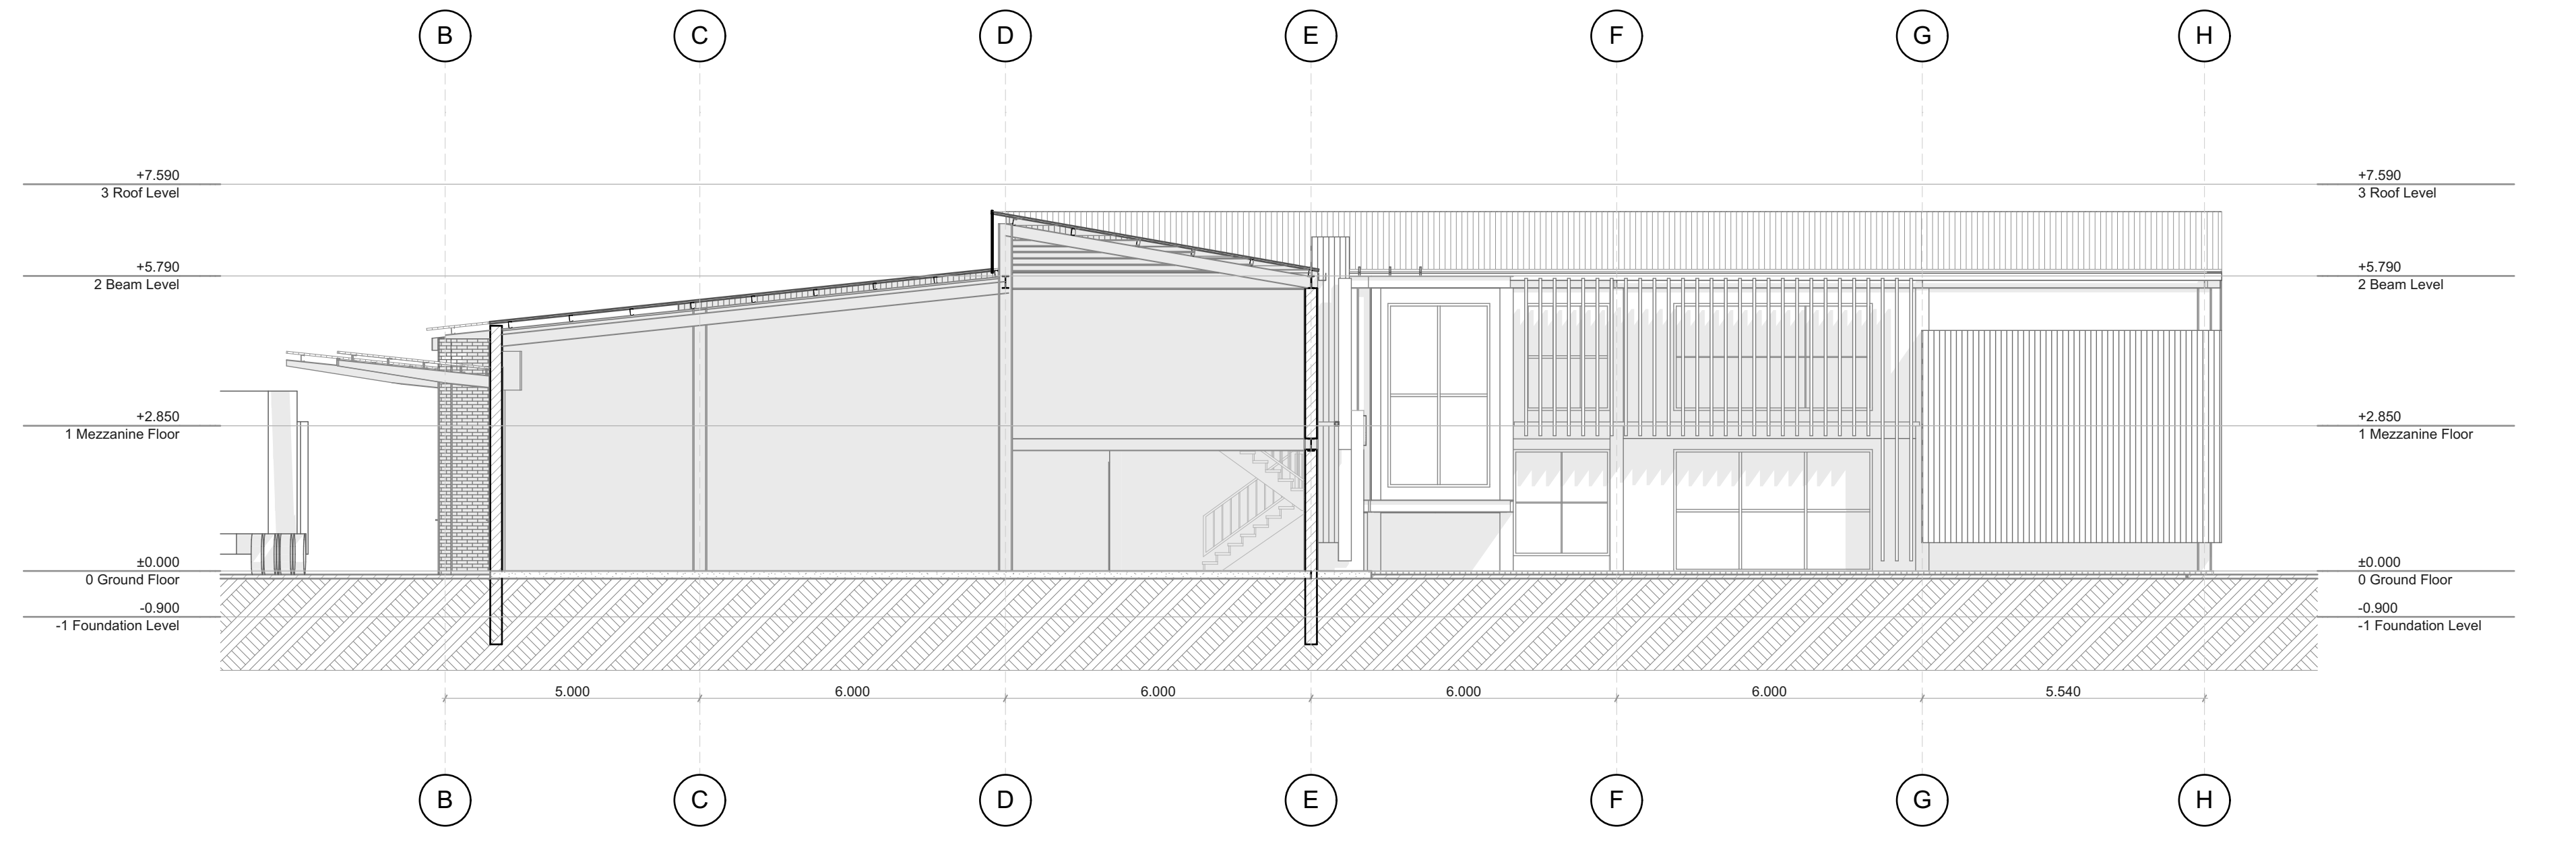

A-A5 Building Section 1:100



A-A4 Building Section 1:100

As Built Drawings

Rev	Chg	Change Name	Date

STAMP:

Drawing Name: Building Section

Drawing Scale: 1:50, 1:100  
 Layout ID: A.01.7  
 Revision: