


North Elevation

1:100




East Elevation

1:100

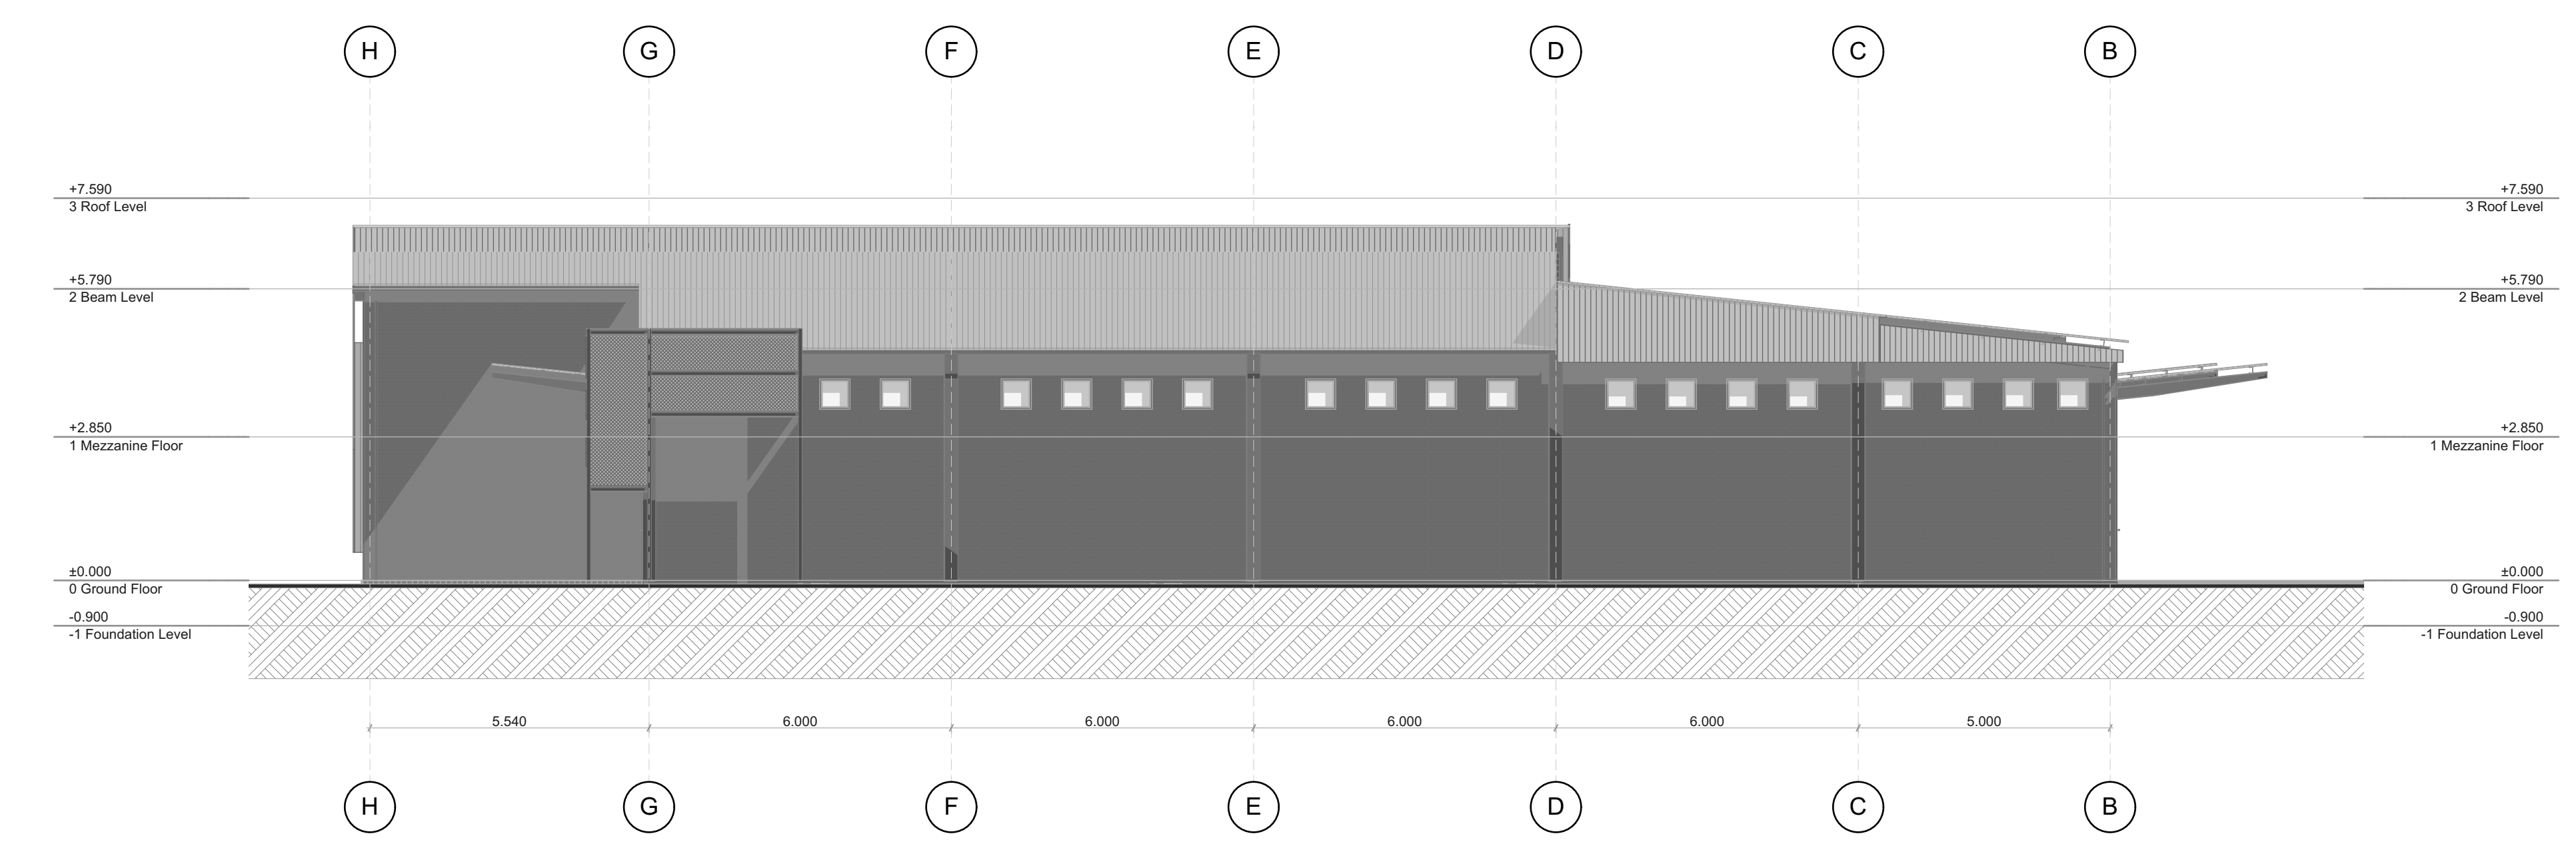

West Elevation

1:100

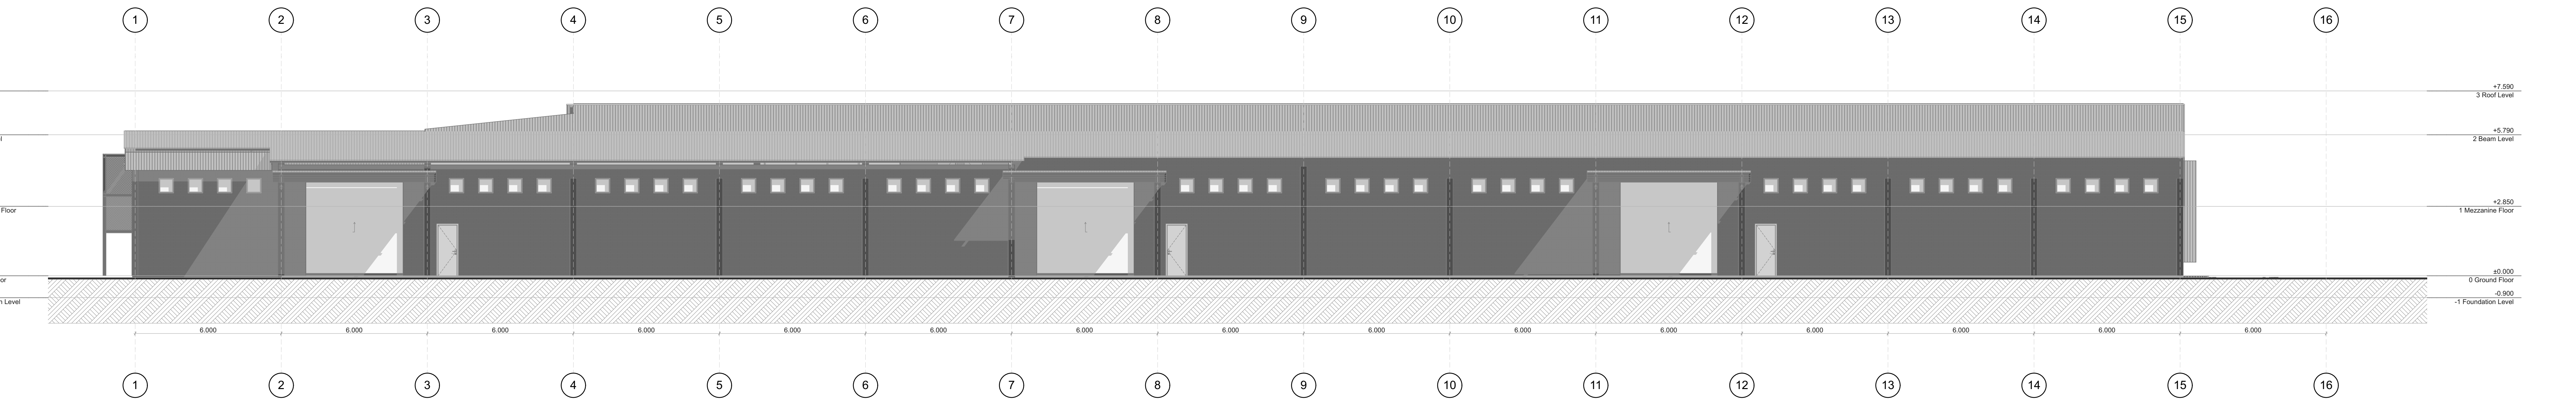

South Elevation

1:100

As Built Drawings

Revision History		
Rev	Chg	Change Name

STAMP:

Drawing Name:
**East Elevation, West Elevation,
 South Elevation, North
 Elevation**

Drawing Scale:
1:100

Layout ID:
A.01.8